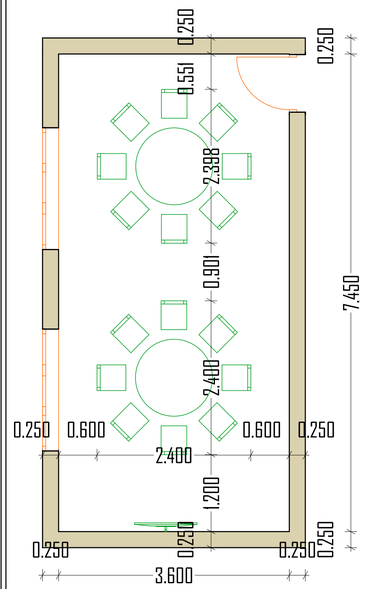

Banquet Round arrangement

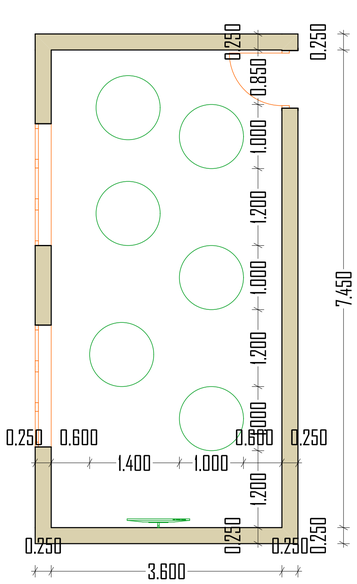


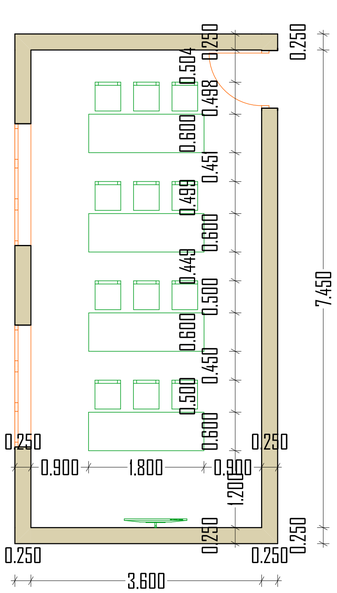

Classroom arrangement

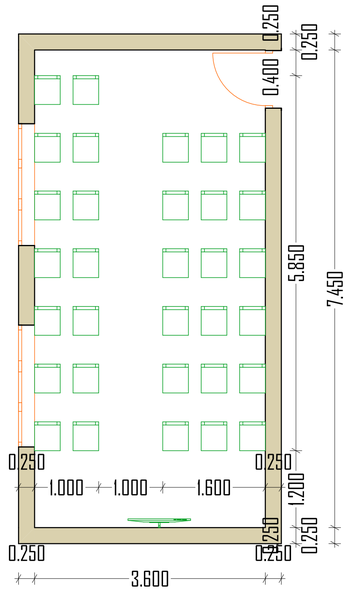

Threatre arrangement

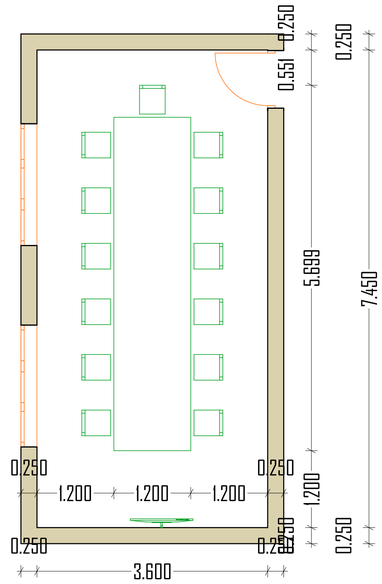

Board room arrangement

Nia Hall

ARCHITECTURAL NOTES.

1. All works to be carried out in accordance with Local Authority regulations.
2. All figured dimensions to be taken in preference to scaled dimensions.
3. All walls below 200mm to be reinforced with hoop iron at every alternative course.
4. Provide damp proof course (D.P.C.) under all walls.
5. P.V. indicates permanent ventilations.
6. All drainage passing under building and drive area to be of pvc pipe and encased in 150mm thick concrete surround.
7. All inspection chambers in drive area to have heavy duty covers.
8. Check all dimensions on site.
9. All sanitary work to be in accordance with MOH rules and regulations and NCC requirements.
10. 500g polythene sheeting and anti-termite treatment to be provided under ground floor concrete slab.
11. All reinforced concrete works to Structural Eng. detail.
12. Automatic booster pump for FHRs to be provided to the satisfaction of the Chief Fire Officer.
13. 4500 litres reserve for hose reel
14. Electrical fire alarm system to the approval of Chief Fire Officer.
15. Fire alarm and booster to be provided with secondary power supply.
16. 2x9 kg Dry Powder Fire Extinguishers at areas shown.
17. 2x9 litre water and 1x4.5 kg CO2 fire extinguishers to be provided per floor.

Revision	Date

TETRA DESIGNS LIMITED
P.O BOX 12814-20100 NAKURU
TEL: +254729528772
EMAIL:tetra.designsltd@gmail.com

Architects signature.....

Client

MIDLAND HOTEL (1977) LTD
P.O BOX 908-20100
NAKURU

Client sign.....

Project Title

PROPOSED RENOVATION FOR MIDLAND HOTEL ON BLOCK NO 9/23 NAKURU

Project No.TDNKR/01/2024/001

Drawing Title

FLOOR PLANS LAYOUT

GROUND FLOOR PLINTH AREA:

Drawing Status

AS BUILT

Drawn by	Design by	Checked by	Date
			JAN, 2024

Scales

1:100

Drawing Number | Status | Revision

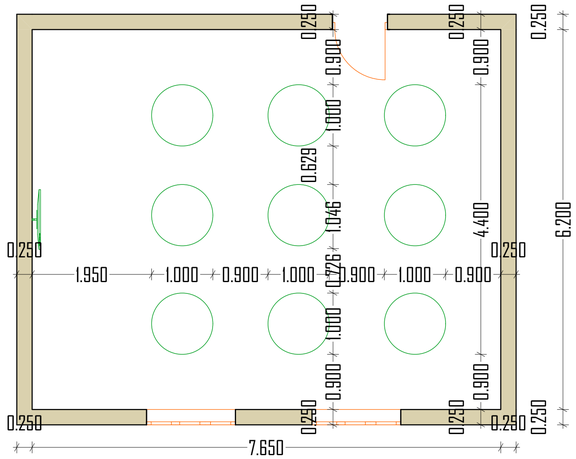

Cock tail arrangement

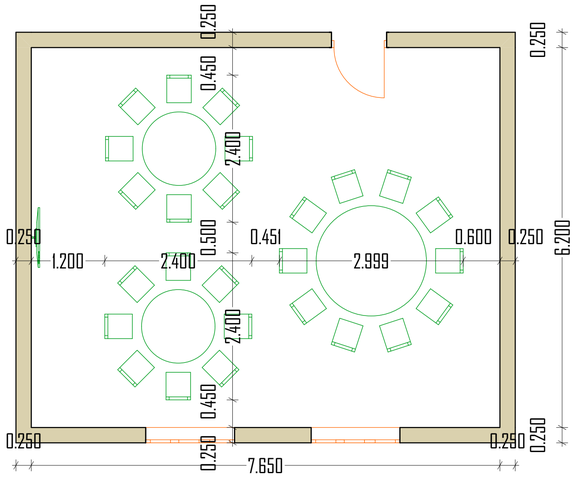

Banquet Round arrangement

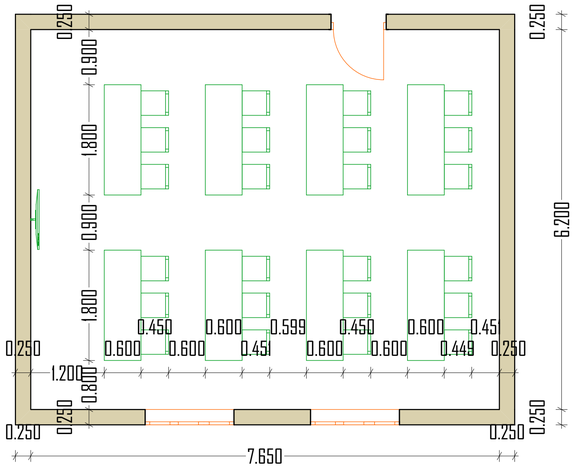

Classroom arrangement

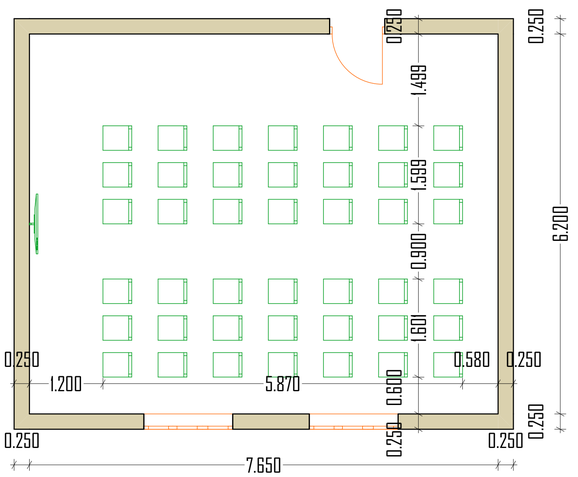

Threatre arrangement

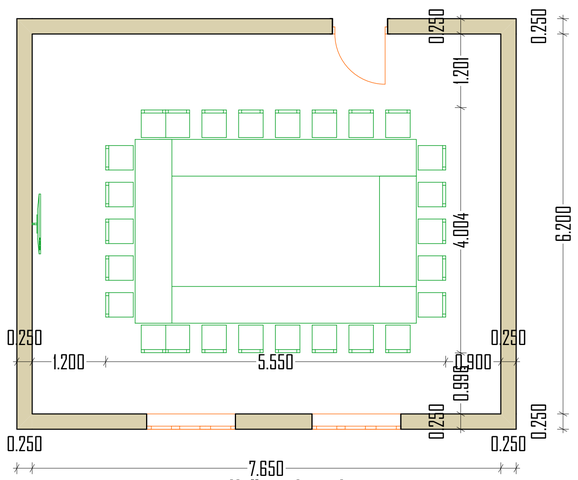

Hollow shaped arrangement

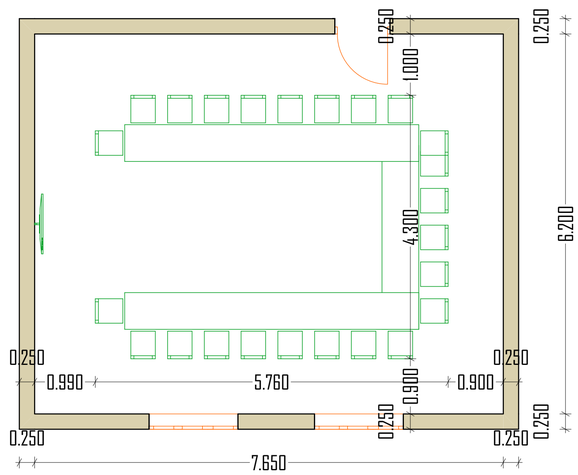

U- shaped arrangement

AMALI

ARCHITECTURAL NOTES.

1. All works to be carried out in accordance with Local Authority regulations.
2. All figured dimensions to be taken in preference to scaled dimensions.
3. All walls below 200mm to be reinforced with hoop iron at every alternative course.
4. Provide damp proof course (D.P.C.) under all walls.
5. P.V. indicates permanent ventilations.
6. All drainage passing under building and drive area to be of pvc pipe and encased in 150mm thick concrete surround.
7. All inspection chambers in drive area to have heavy duty covers.
8. Check all dimensions on site.
9. All sanitary work to be in accordance with MOH rules and regulations and NCC requirements.
10. 500g polythene sheeting and anti-termite treatment to be provided under ground floor concrete slab.
11. All reinforced concrete works to Structural Eng. detail.
12. Automatic booster pump for FHRs to be provided to the satisfaction of the Chief Fire Officer.
13. 4500 litres reserve for hose reel
14. Electrical fire alarm system to the approval of Chief Fire Officer.
15. Fire alarm and booster to be provided with secondary power supply.
16. 2x9 kg Dry Powder Fire Extinguishers at areas shown.
17. 2x9 litre water and 1x4.5 kg CO_2 fire extinguishers to be provided per floor.

Revision	Date

TETRA DESIGNS LIMITED
P.O BOX 12814-20100 NAKURU
TEL: +254729528772
EMAIL:tetra.designsltd@gmail.com

Architects signature.....

Client

MIDLAND HOTEL (1977) LTD
P.O BOX 908-20100
NAKURU

Client sign.....

Project Title

PROPOSED RENOVATION FOR MIDLAND HOTEL ON BLOCK NO 9/23 NAKURU

Project No.TDNKR/01/2024/001

Drawing Title

FLOOR PLANS LAYOUT

GROUND FLOOR PLINTH AREA:

Drawing Status

AS BUILT

Drawn by	Design by	Checked by	Date
			JAN, 2024

Scales

1:100

Drawing Number | Status | Revision

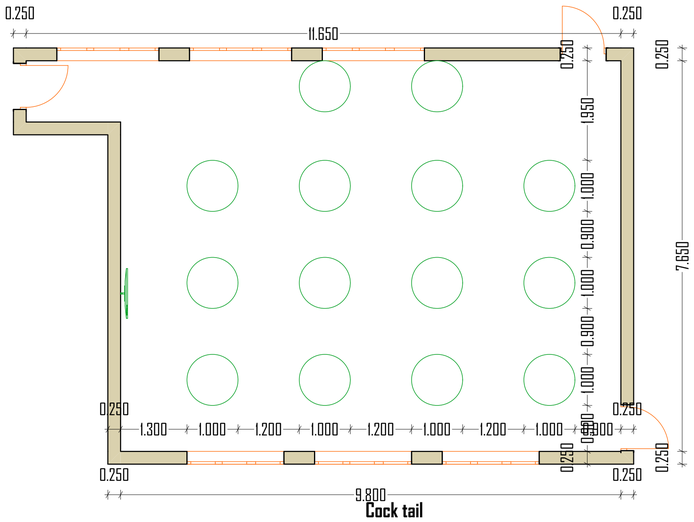

Cock tail arrangement

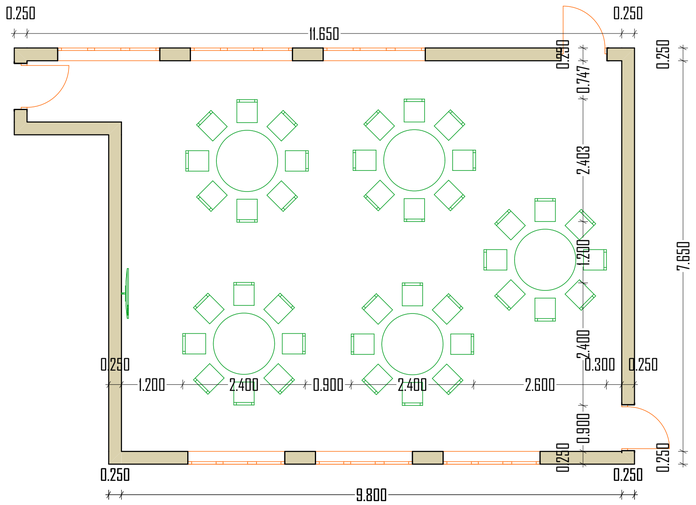

Banquet Round arrangement

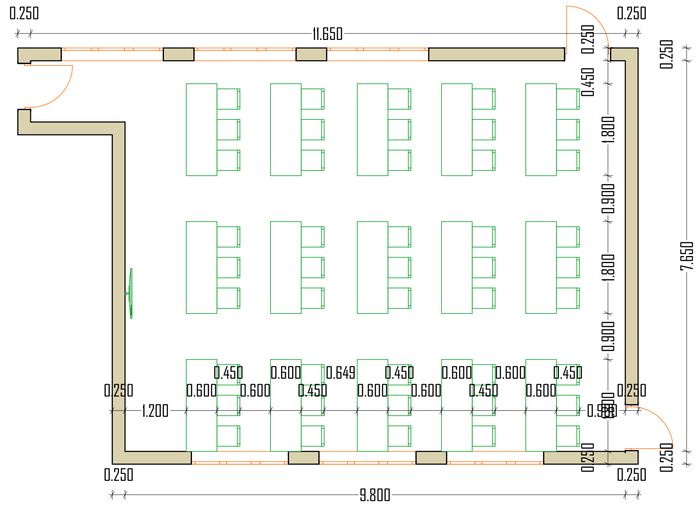

Classroom arrangement

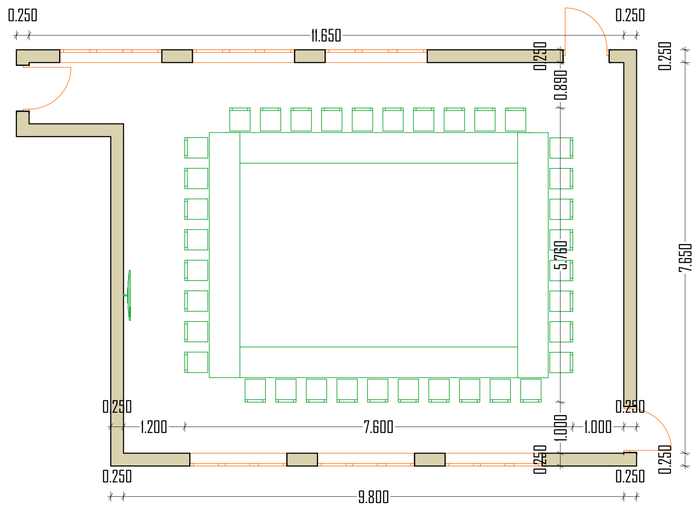

Hollow shaped arrangement

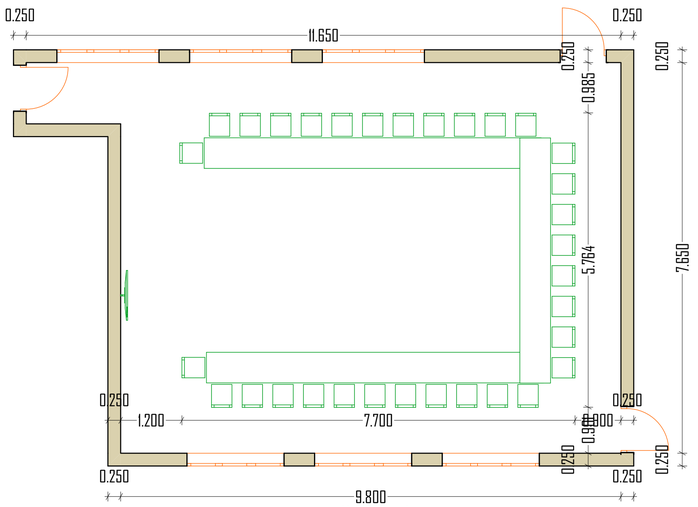

U- shaped arrangement

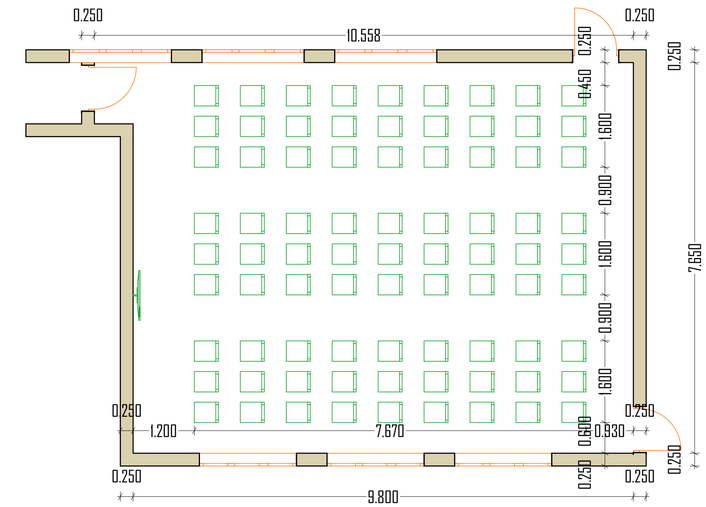

Threatre arrangement

Inaya Hall

ARCHITECTURAL NOTES.

1. All works to be carried out in accordance with Local Authority regulations.
2. All figured dimensions to be taken in preference to scaled dimensions.
3. All walls below 200mm to be reinforced with hoop iron at every alternative course.
4. Provide damp proof course (D.P.C.) under all walls.
5. P.V. indicates permanent ventilations.
6. All drainage passing under building and drive area to be of pvc pipe and encased in 150mm thick concrete surround.
7. All inspection chambers in drive area to have heavy duty covers.
8. Check all dimensions on site.
9. All sanitary work to be in accordance with MOH rules and regulations and NCC requirements.
10. 500g polythene sheeting and anti-termite treatment to be provided under ground floor concrete slab.
11. All reinforced concrete works to Structural Eng. detail.
12. Automatic booster pump for FHRs to be provided to the satisfaction of the Chief Fire Officer.
13. 4500 litres reserve for hose reel
14. Electrical fire alarm system to the approval of Chief Fire Officer.
15. Fire alarm and booster to be provided with secondary power supply.
16. 2x9 kg Dry Powder Fire Extinguishers at areas shown.
17. 2x9 litre water and 1x4.5 kg CO2 fire extinguishers to be provided per floor.

Revision	Date

TETRA DESIGNS LIMITED
P.O BOX 12814-20100 NAKURU
TEL: +254729528772
EMAIL:tetra.designsltd@gmail.com

Architects signature.....

Client

MIDLAND HOTEL (1977) LTD
P.O BOX 908-20100
NAKURU

Client sign.....

Project Title

PROPOSED RENOVATION FOR MIDLAND HOTEL ON BLOCK NO 9/23 NAKURU

Project No.TDNKR/01/2024/001

Drawing Title

FLOOR PLANS LAYOUT

GROUND FLOOR PLINTH AREA:

Drawing Status

AS BUILT

Drawn by	Design by	Checked by	Date
			JAN, 2024

Scales

1:100

Drawing Number | Status | Revision

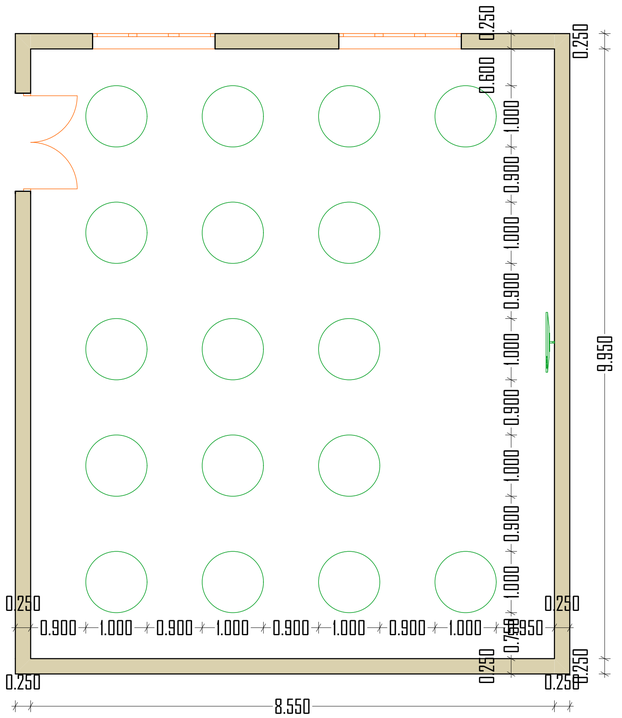

Cock tail arrangement

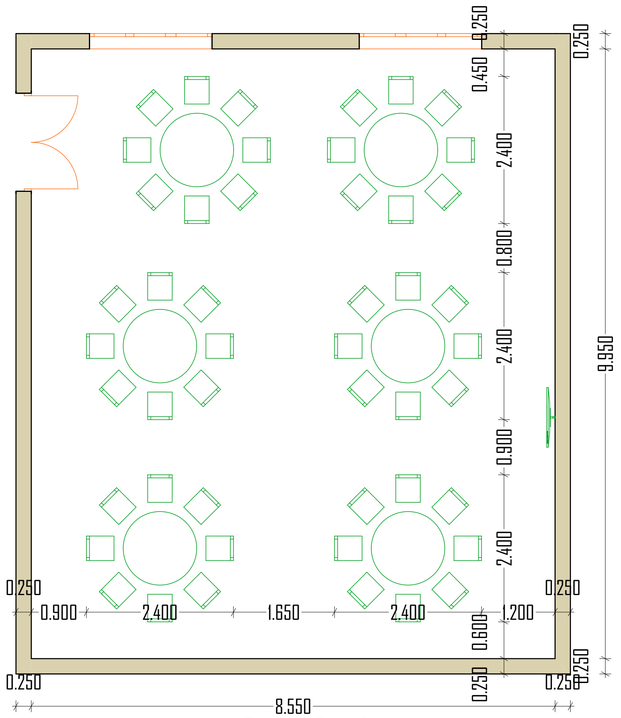

Banquet Round arrangement

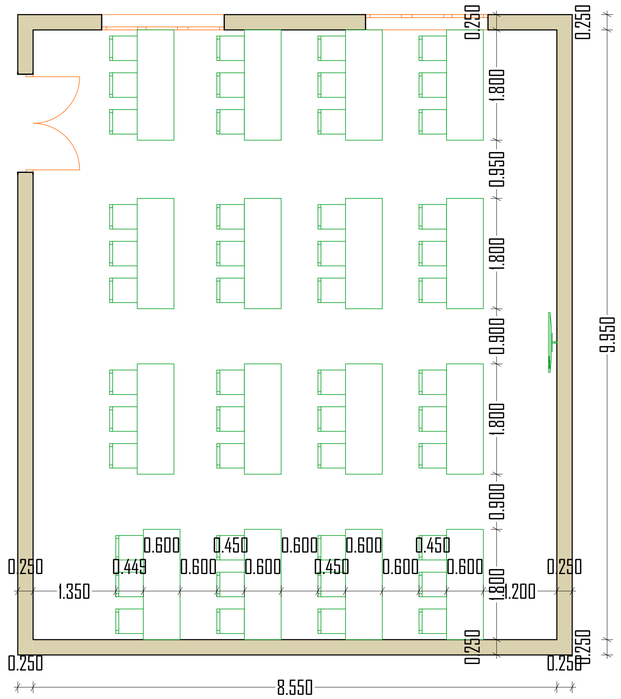

Classroom arrangement

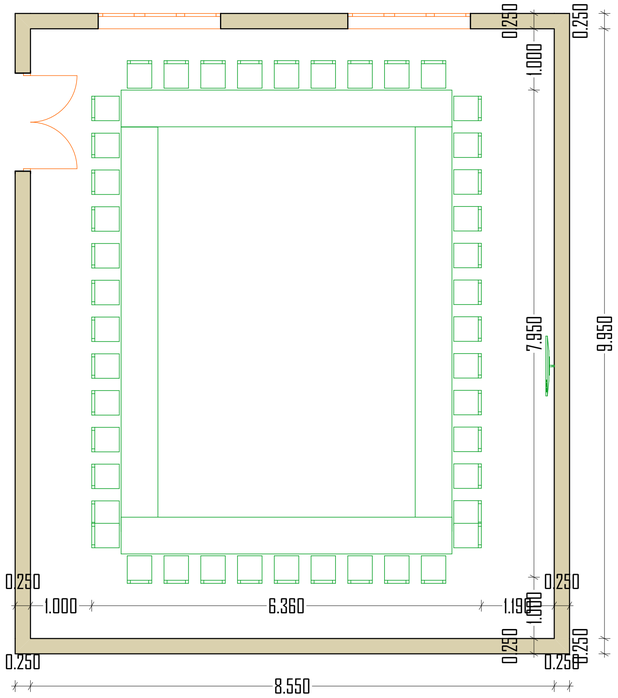

Hollow shaped arrangement

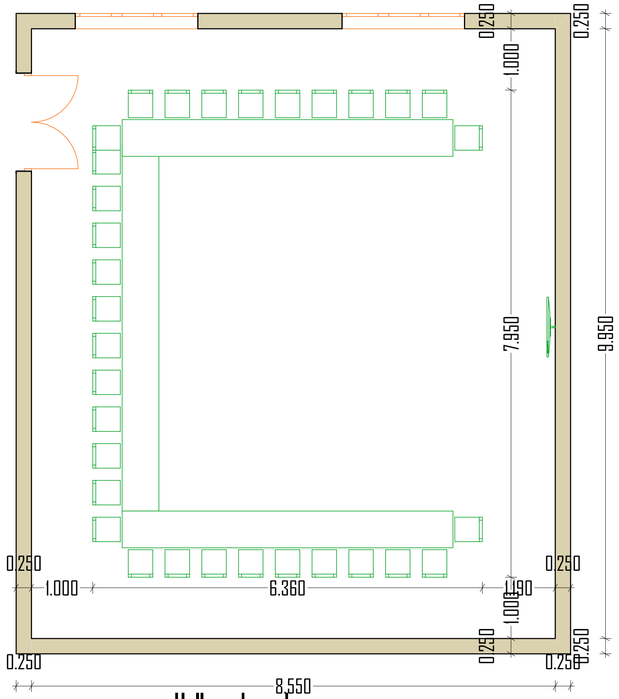


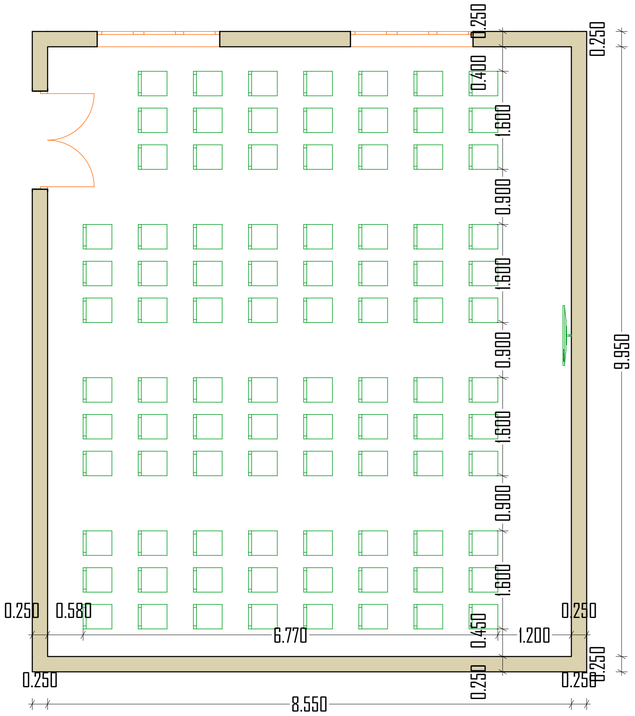

Threatre arrangement

Johari Hall

ARCHITECTURAL NOTES.

1. All works to be carried out in accordance with Local Authority regulations.
2. All figured dimensions to be taken in preference to scaled dimensions.
3. All walls below 200mm to be reinforced with hoop iron at every alternative course.
4. Provide damp proof course (D.P.C.) under all walls.
5. P.V. indicates permanent ventilations.
6. All drainage passing under building and drive area to be of pvc pipe and encased in 150mm thick concrete surround.
7. All inspection chambers in drive area to have heavy duty covers.
8. Check all dimensions on site.
9. All sanitary work to be in accordance with MOH rules and regulations and NCC requirements.
10. 500g polythene sheeting and anti-termite treatment to be provided under ground floor concrete slab.
11. All reinforced concrete works to Structural Eng. detail.
12. Automatic booster pump for FHRs to be provided to the satisfaction of the Chief Fire Officer.
13. 4500 litres reserve for hose reel
14. Electrical fire alarm system to the approval of Chief Fire Officer.
15. Fire alarm and booster to be provided with secondary power supply.
16. 2x9 kg Dry Powder Fire Extinguishers at areas shown.
17. 2x9 litre water and 1x4.5 kg CO2 fire extinguishers to be provided per floor.

Revision	Date

TETRA DESIGNS LIMITED
P.O BOX 12814-20100 NAKURU
TEL: +254729528772
EMAIL:tetra.designsltd@gmail.com

Architects signature.....

Client

MIDLAND HOTEL (1977) LTD
P.O BOX 908-20100
NAKURU

Client sign.....

Project Title

PROPOSED RENOVATION FOR MIDLAND HOTEL ON BLOCK NO 9/23 NAKURU

Project No.TDNKR/01/2024/001

Drawing Title

FLOOR PLANS LAYOUT

GROUND FLOOR PLINTH AREA:

Drawing Status

AS BUILT

Drawn by	Design by	Checked by	Date
			JAN, 2024

Scales

1:100

Drawing Number | Status | Revision

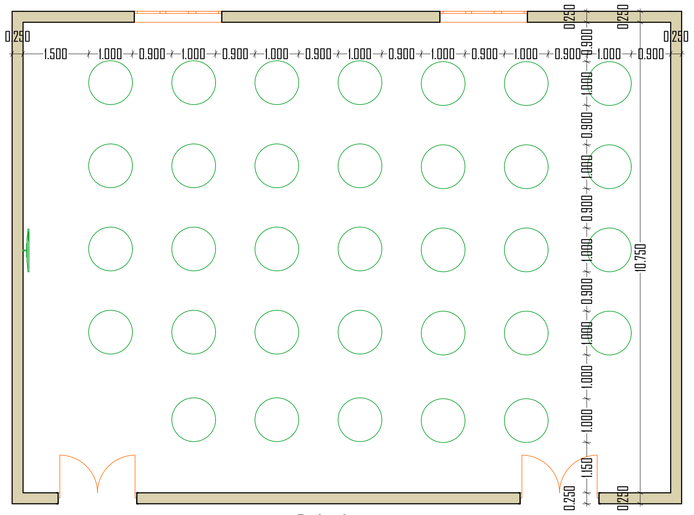

Cock tail arrangement

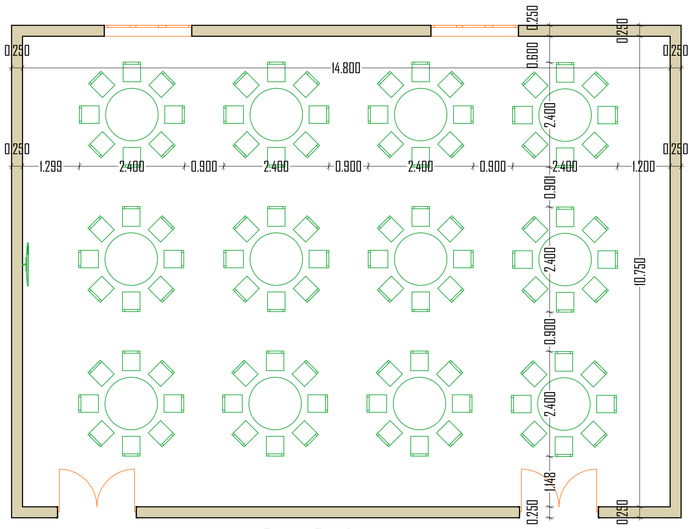

Banquet Round arrangement

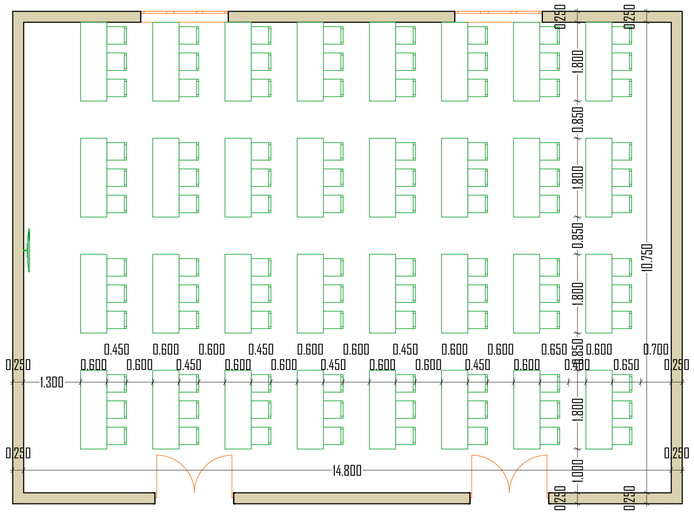

Classroom arrangement

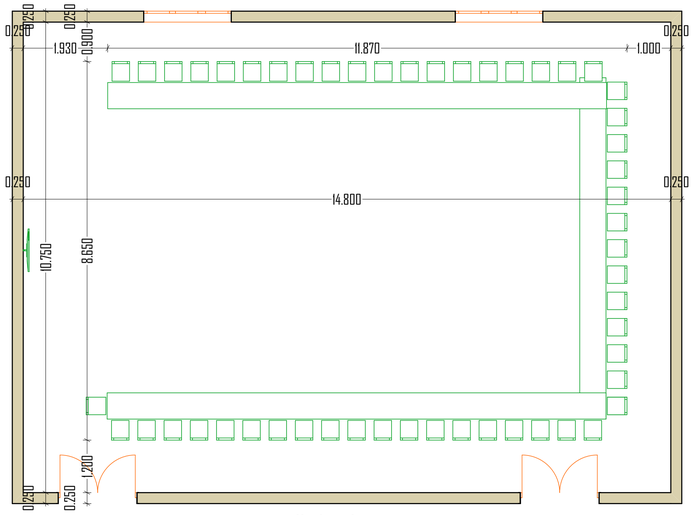

U- shaped arrangement

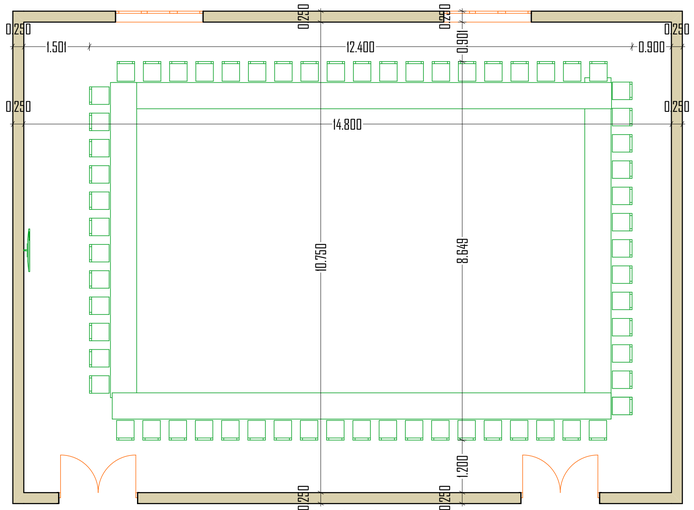

Hollow shaped arrangement

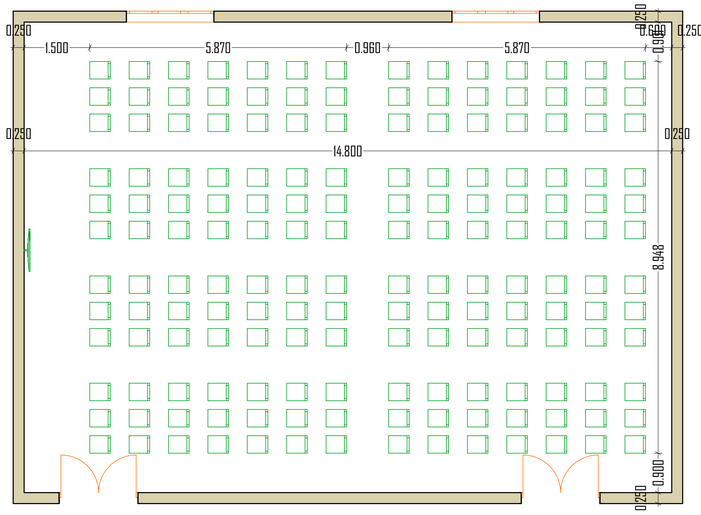

Threatre arrangement

Uhuru Hall

ARCHITECTURAL NOTES.

1. All works to be carried out in accordance with Local Authority regulations.
2. All figured dimensions to be taken in preference to scaled dimensions.
3. All walls below 200mm to be reinforced with hoop iron at every alternative course.
4. Provide damp proof course (D.P.C.) under all walls.
5. P.V. indicates permanent ventilations.
6. All drainage passing under building and drive area to be of pvc pipe and encased in 150mm thick concrete surround.
7. All inspection chambers in drive area to have heavy duty covers.
8. Check all dimensions on site.
9. All sanitary work to be in accordance with MOH rules and regulations and NCC requirements.
10. 500g polythene sheeting and anti-termite treatment to be provided under ground floor concrete slab.
11. All reinforced concrete works to Structural Eng. detail.
12. Automatic booster pump for FHRs to be provided to the satisfaction of the Chief Fire Officer.
13. 4500 litres reserve for hose reel
14. Electrical fire alarm system to the approval of Chief Fire Officer.
15. Fire alarm and booster to be provided with secondary power supply.
16. 2x9 kg Dry Powder Fire Extinguishers at areas shown.
17. 2x9 litre water and 1x4.5 kg CO2 fire extinguishers to be provided per floor.

Revision	Date

TETRA DESIGNS LIMITED
P.O BOX 12814-20100 NAKURU
TEL: +254729528772
EMAIL:tetra.designsltd@gmail.com

Architects signature.....

Client

MIDLAND HOTEL (1977) LTD
P.O BOX 908-20100
NAKURU

Client sign.....

Project Title

PROPOSED RENOVATION FOR MIDLAND HOTEL ON BLOCK NO 9/23 NAKURU

Project No.TDNKR/01/2024/001

Drawing Title

FLOOR PLANS LAYOUT

GROUND FLOOR PLINTH AREA:

Drawing Status

AS BUILT

Drawn by	Design by	Checked by	Date
			JAN, 2024

Scales

1:100

Drawing Number | Status | Revision

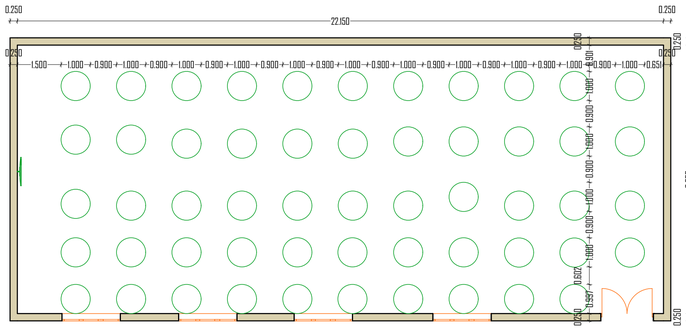

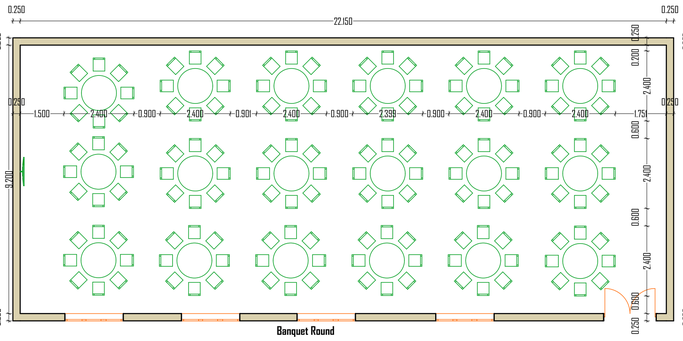

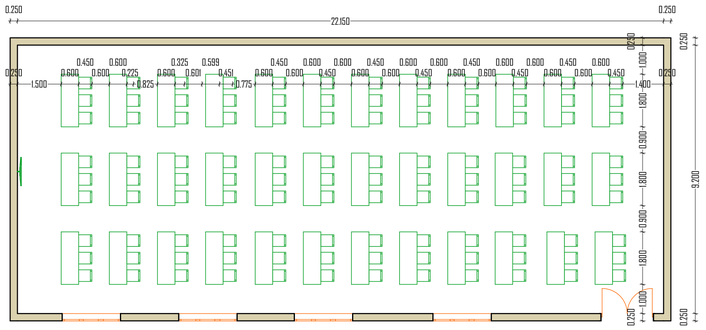

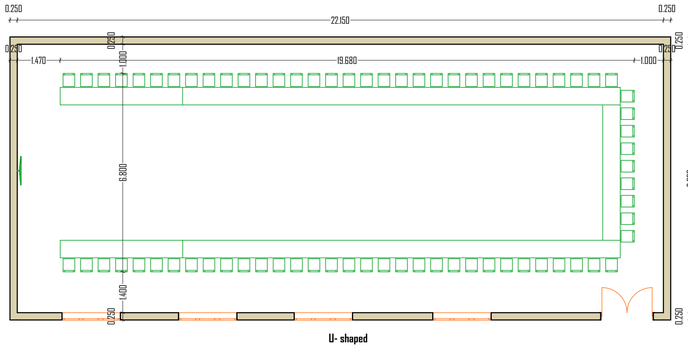

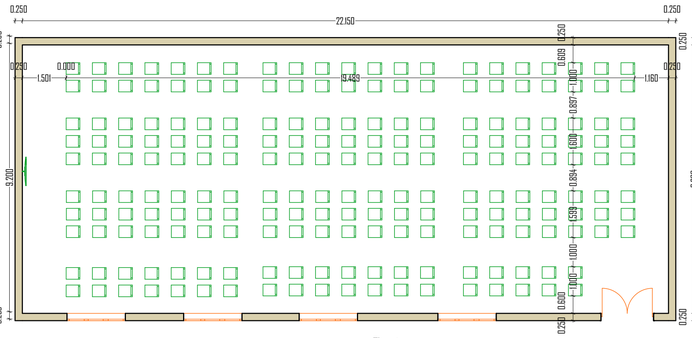

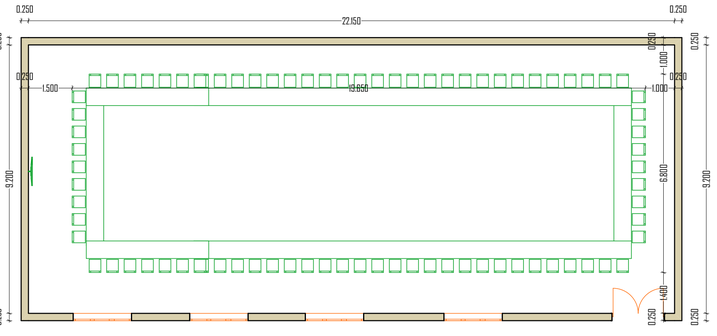

Conference hall

ARCHITECTURAL NOTES.

1. All works to be carried out in accordance with Local Authority regulations.
2. All figured dimensions to be taken in preference to scaled dimensions.
3. All walls below 200mm to be reinforced with hoop iron at every alternative course.
4. Provide damp proof course (D.P.C.) under all walls.
5. P.V. indicates permanent ventilations.
6. All drainage passing under building and drive area to be of pvc pipe and encased in 150mm thick concrete surround.
7. All inspection chambers in drive area to have heavy duty covers.
8. Check all dimensions on site.
9. All sanitary work to be in accordance with MOH rules and regulations and NCC requirements.
10. 500g polythene sheeting and anti-termite treatment to be provided under ground floor concrete slab.
11. All reinforced concrete works to Structural Eng. detail.
12. Automatic booster pump for FHRs to be provided to the satisfaction of the Chief Fire Officer.
13. 4500 litres reserve for hose reel
14. Electrical fire alarm system to the approval of Chief Fire Officer.
15. Fire alarm and booster to be provided with secondary power supply.
16. 2x9 kg Dry Powder Fire Extinguishers at areas shown.
17. 2x9 litre water and 1x4.5 kg CO2 fire extinguishers to be provided per floor.

Revision	Date

TETRA DESIGNS LIMITED
P.O BOX 12814-20100 NAKURU
TEL: +254729528772
EMAIL:tetra.designsltd@gmail.com

Architects signature.....

Client

MIDLAND HOTEL (1977) LTD
P.O BOX 908-20100
NAKURU

Client sign.....

Project Title

PROPOSED RENOVATION FOR MIDLAND HOTEL ON BLOCK NO 9/23 NAKURU

Project No.TDNKR/01/2024/001

Drawing Title

FLOOR PLANS LAYOUT

GROUND FLOOR PLINTH AREA:

Drawing Status

AS BUILT

Drawn by	Design by	Checked by	Date
			JAN, 2024

Scales

1:100

Drawing Number	Status	Revision